



SAN FRANCISCO PLANNING DEPARTMENT

MEMO

Disclaimer for Review of Plans

The San Francisco Planning Code requires that the plans of certain proposed projects be provided to members of the public prior to the City's approval action on the project. Accordingly, any images of plans featured on this website are provided for the primary purpose of facilitating public input prior to the City's action. The City and County of San Francisco does not own the copyright to these images. Please be aware that the unauthorized reproduction, distribution, or alteration of these images may result in a violation of Federal Copyright Law (17 U.S.C.A. Sections 101 et seq.) and that any party who seeks to reproduce or alter these images does so at his or her own risk.

Additionally, plans provided on this website are limited to site plans, elevations and/or section details (floor plans and structural details may not be included). These are DRAFT PLANS being provided for public review PRIOR to the City's approval action on the project. Final plans may differ from those that are currently available for review.

1650 Mission St.
Suite 400
San Francisco,
CA 94103-2479

Reception:
415.558.6378

Fax:
415.558.6409

Planning
Information:
415.558.6377



SAN FRANCISCO PLANNING DEPARTMENT

1650 Mission Street, Suite 400 • San Francisco, CA 94103 • Fax (415) 558-6409

NOTICE OF PUBLIC HEARING

Hearing Date: **Wednesday, August 24, 2011**
Time: **Beginning at 9:30 AM**
Location: **Planning Department, 1650 Mission Street,
Suite 400, Room 431**
Case Type: **Variance (Rear Yard)**
Hearing Body: **Zoning Administrator**

PROPERTY INFORMATION		APPLICATION INFORMATION	
Project Address:	1465 De Haro Street	Case No.:	2011.0572V
Cross Street(s):	btw 25th and 26th Streets	Building Permit:	TBD
Block /Lot No.:	4283B / 031	Applicant/Agent:	Paul Colfer
Zoning District(s):	RH-1 / 40-X	Telephone:	(415) 568-5082

PROJECT DESCRIPTION

The proposal is to replace and expand the existing second floor rear deck. The replacement deck will be approximately 8 feet above grade. The proposal will not add square footage to the existing building.

PER SECTION 143 OF THE PLANNING CODE the subject property is required to maintain a required rear yard of 25 percent of lot depth. The subject lot is approximately 74 feet deep and the required rear yard is approximately 18.5 feet. The existing deck encroaches approximately 3.5 feet into the required rear yard. The proposed deck replacement will encroach an additional 2 feet into the required rear yard, leaving a rear yard of approximately 13 feet. Therefore, this project requires a rear yard variance.

ADDITIONAL INFORMATION

ARCHITECTURAL PLANS: The site plan and elevations of the proposed project are available on the Planning Department's website at: <http://sf-planning.org/ftp/files/notice/2011.0572V.pdf>

FOR MORE INFORMATION, PLEASE CONTACT PLANNING DEPARTMENT STAFF:

Planner: **Erika S. Jackson** Telephone: **(415) 558-6363** E-Mail: erika.jackson@sfgov.org

中文詢問請電: **558.6378**

Para información en Español llamar al: **558.6378**

GENERAL INFORMATION ABOUT PROCEDURES

VARIANCE HEARING INFORMATION

Under Planning Code Section 306.3, you, as a property owner or resident within 300 feet of this proposed project or interested party on record with the Planning Department, are being notified of this Variance Hearing. **You are not obligated to take any action. For more information regarding the proposed work, or to express concerns about the project, please contact the Applicant/Agent or Planner listed on this notice as soon as possible.** Additionally, you may wish to discuss the project with your neighbors and neighborhood association or improvement club, as they may already be aware of the project.

Persons who are unable to attend the public hearing may submit written comments regarding this application to the Zoning Administrator, Planning Department, 1650 Mission Street, Suite 400, San Francisco, CA 94103, by 5:00pm the day prior to the hearing. These comments will be made a part of the official public record, and will be brought to the attention of the person or persons conducting the public meeting or hearing.

BUILDING PERMIT APPLICATION INFORMATION

Under Planning Code Section 311/312, the Building Permit Application for this proposal is also subject to a 30-day notification to occupants and owners within 150-feet of the subject property. **The mailing of such notification will be performed separately.**

BOARD OF APPEALS

An appeal of the approval (or denial) of a **variance application** by the Zoning Administrator may be made to the **Board of Appeals within 10 days** after the **Variance Decision Letter** is issued by the Zoning Administrator.

An appeal of the approval (or denial) of a **building permit application** by the Planning Department may be made to the **Board of Appeals within 15 days** after the **building permit** is issued (or denied) by the Director of the Department of Building Inspection.

Appeals must be submitted in person at the **Board's office at 1650 Mission Street, 3rd Floor, Room 304**. For further information about appeals to the Board of Appeals, including current fees, **contact the Board of Appeals at (415) 575-6880**.


ABOUT THIS NOTICE

The Planning Department is currently reviewing its processes and procedures for public notification as part of the Universal Planning Notification (UPN) Project. The format of this Public Hearing notice was developed through the UPN Project and is currently being utilized in a limited trial-run for notification of Variance Hearings.

If you have any comments or questions related to the UPN Project or the format of this notice, please visit our website at <http://upn.sfplanning.org> for more information.


DRAWING INDEX

- A1 SITE PLAN
- A2 AS-BUILT EXISTING DECK PLAN: GROUND LEVEL
- A3 AS-BUILT EXISTING DECK PLAN: SECOND LEVEL
- A4 NEW DECK PLAN: SECOND LEVEL
- A5 NEW SIDE ELEVATION / NEW REAR YARD ELEVATION
- A6 NEW DECK FOUNDATION PLAN
- A7 NEW DECK FRAMING PLAN: SECOND LEVEL
- A8 NEW RAILING FRAMING PLAN: SECOND LEVEL
- A9 SECTION DETAIL A

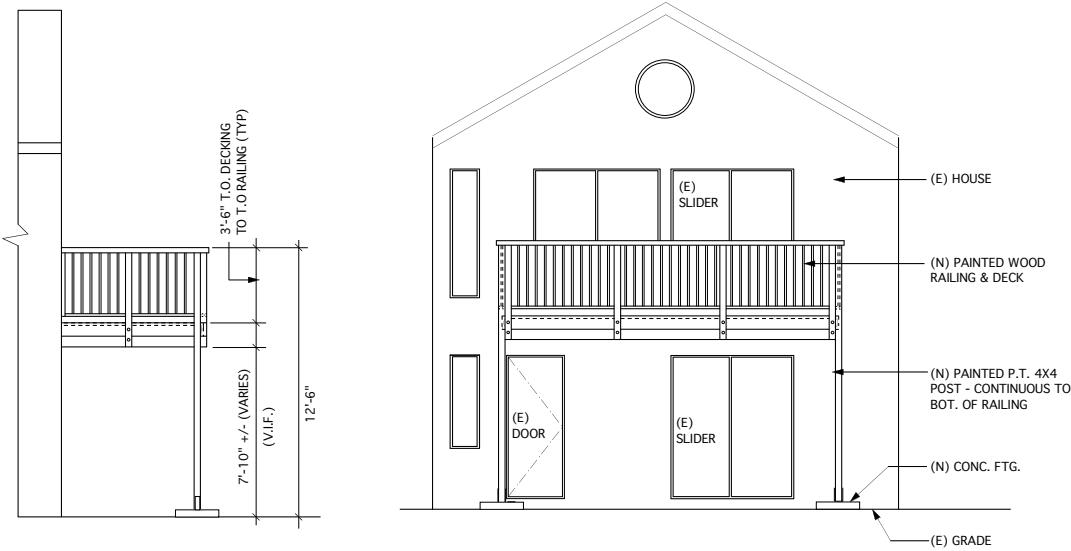


A-5 NEW SIDE ELEVATION
1/4" = 1'-0"


NEW REAR YARD ELEVATION

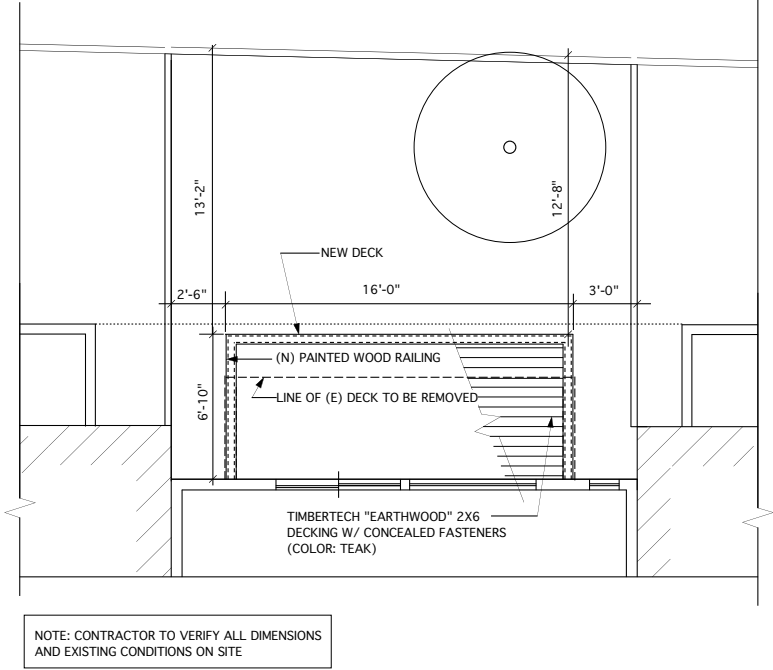


A-4 NEW DECK PLAN: SECOND LEVEL
1/4" = 1'-0"

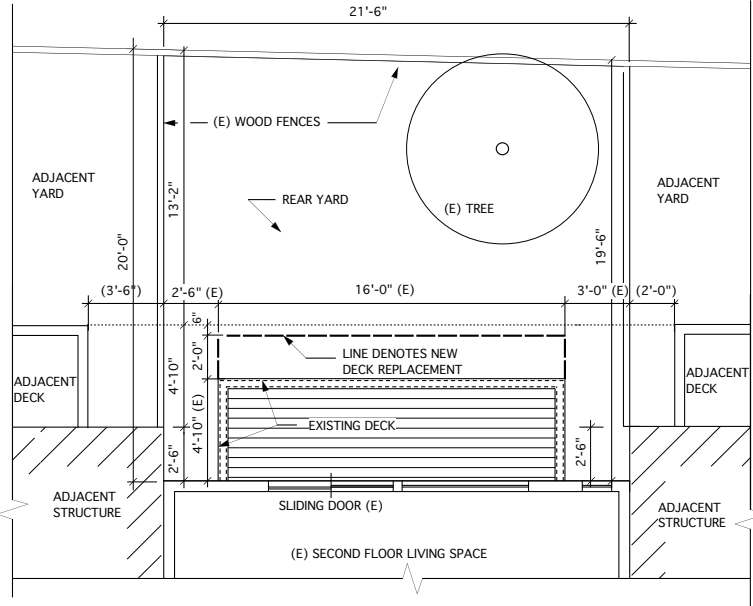

A-3 AS-BUILT EXISTING DECK PLAN: SECOND LEVEL
1/4" = 1'-0"

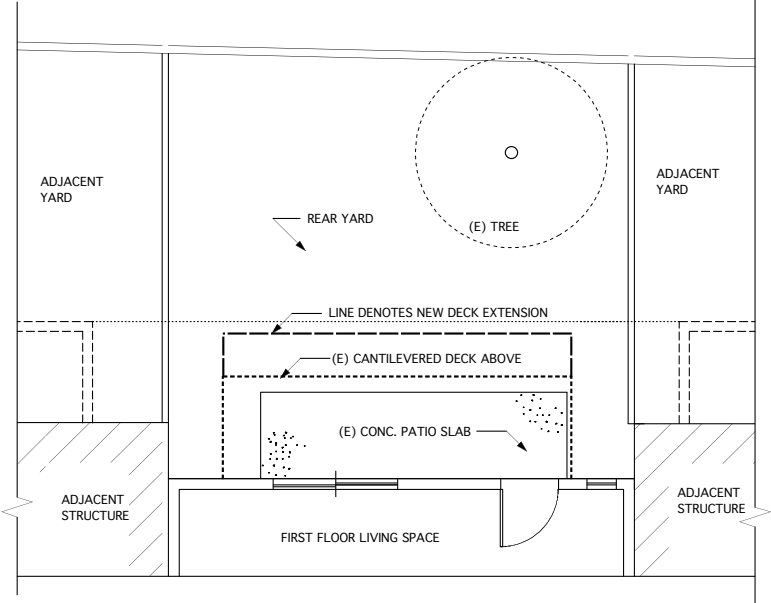

A-2 AS-BUILT EXISTING DECK PLAN: GROUND LEVEL
1/4" = 1'-0"

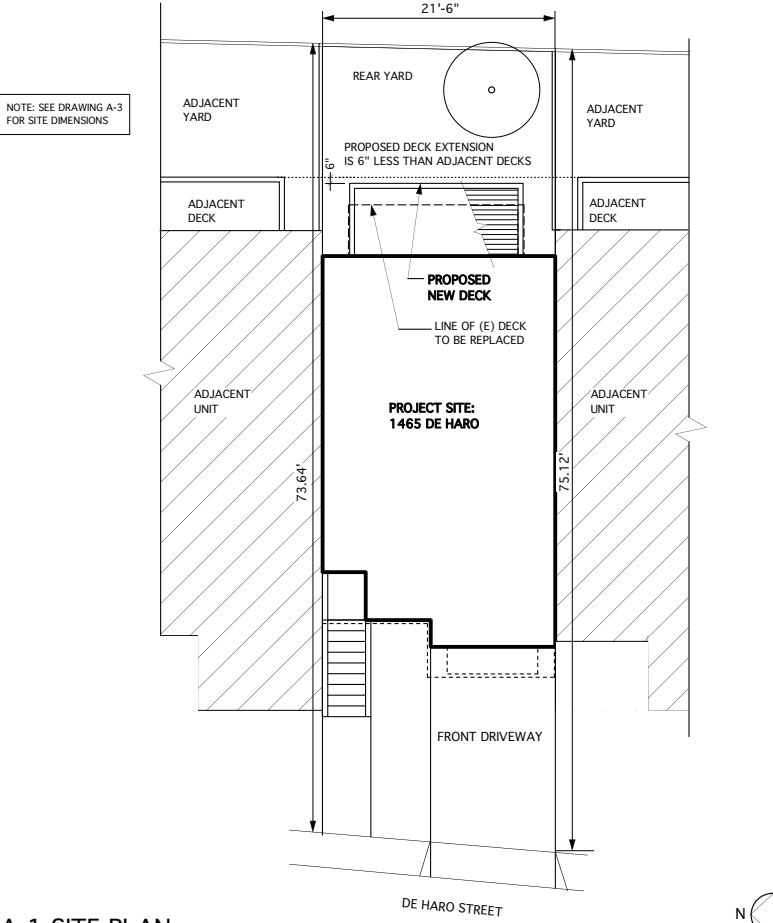

A-1 SITE PLAN
1/8" = 1'-0"

FAULDERS STUDIO
Thom Faulders Architect
1571 Ninth Street
Berkeley, CA 94710
t:510 693.0013

Site Plan; As-built Plans;
Proposed Plans, Elevations

Project:
COLFERGATTO DECK
EXTENSION
1465 De Haro Street
San Francisco, CA 94107

Revisions	REV	DATE	DESCRIPTION
	1	11.1.15.10	

Date Printed: 10.28.10
Drawn:
Scale: AS SHOWN
Job No. COLFER

1.0