### MEMO

# **Disclaimer for Review of Plans**

The San Francisco Planning Code requires that the plans of certain proposed projects be provided to members of the public prior to the City's approval action on the project. Accordingly, any images of plans featured on this website are provided for the primary purpose of facilitating public input prior to the City's action. The City and County of San Francisco does not own the copyright to these images. Please be aware that the unauthorized reproduction, distribution, or alteration of these images may result in a violation of Federal Copyright Law (17 U.S.C.A. Sections 101 et seq.) and that any party who seeks to reproduce or alter these images does so at his or her own risk.

Additionally, plans provided on this website are limited to site plans, elevations and/or section details (floor plans and structural details may not be included). These are DRAFT PLANS being provided for public review PRIOR to the City's approval action on the project. Final plans may differ from those that are currently available for review.

1650 Mission St. Suite 400 San Francisco, CA 94103-2479

Reception: 415.558.6378

Fax: 415.558.6409

Planning Information: 415.558.6377 **NOTICE OF PUBLIC HEARING** 

Hearing Date: Wednesday, December 4, 2013

Time: **9:30 AM** 

Location: City Hall, 1 Dr. Carlton B. Goodlett Place, Room 408

Case Type: Variance (Rear Yard)
Hearing Body: Zoning Administrator

PORPERTY INFORMATION		APPLICATION INFORMATION	
Project Address:	3647 22nd St	Case No.:	2013.1267V
Cross Street(s):	22nd St. & Sanchez St.	Building Permit:	2013.0708.1319
Block / Lot No.:	3627/045	Applicant/Agent:	Lisa Caccavo
Zoning District(s):	RH-2 / 40-X	Telephone:	415-424-4642
Area Plan:	N/A	E-Mail:	Lcaccavo@yahoo.com

### PROJECT DESCRIPTION

The proposal is to legalize an existing dwelling unit and infill a side area of the existing building. The lot is 25 feet wide and 100 feet deep, with an 8-foot wide portion extending to 128 feet deep. The existing building encroaches 20 feet 6 inches into the required rear yard. The proposed side infill is 3 feet 9 inches wide and 15 feet 3 inches deep, and will not expand the overall extents of the building. Additional work includes interior work and a new street tree.

**PER SECTION 134 OF THE PLANNING CODE** the subject property is required to maintain a rear yard of approximately 45 feet. The proposed infill located at the side of the first and second story encroaches approximately 9 feet 8 inches into the required rear yard, and thus requires a variance from the rear yard requirement.

### ADDITIONAL INFORMATION

FOR MORE INFORMATION, PLEASE CONTACT PLANNING DEPARTMENT STAFF:

Planner: Jeffrey Speirs Telephone: 415-575-9106 E-Mail: Jeffrey.speirs@sfgov.org

**ARCHITECTURAL PLANS:** The site plan and elevations of the proposed project are available on the Planning Department's website at: <a href="http://sf-planning.org/ftp/files/notice/2013.1267V.pdf">http://sf-planning.org/ftp/files/notice/2013.1267V.pdf</a>

中文詢問請電:558.6378

Para información en Español llamar al: 558.6378

### GENERAL INFORMATION ABOUT PROCEDURES

### **VARIANCE HEARING INFORMATION**

Under Planning Code Section 306.3, you, as a property owner or resident within 300 feet of this proposed project or interested party on record with the Planning Department, are being notified of this Variance Hearing. You are not obligated to take any action. For more information regarding the proposed work, or to express concerns about the project, please contact the Applicant/Agent or Planner listed on this notice as soon as possible. Additionally, you may wish to discuss the project with your neighbors and neighborhood association or improvement club, as they may already be aware of the project.

Persons who are unable to attend the public hearing may submit written comments regarding this application to the Zoning Administrator, Planning Department, 1650 Mission Street, Suite 400, San Francisco, CA 94103, by 5:00pm the day prior to the hearing. These comments will be made a part of the official public record, and will be brought to the attention of the person or persons conducting the public meeting or hearing

### **BUILDING PERMIT APPLICATION INFORMATION**

Under Planning Code Section 311/312, the Building Permit Application for this proposal is also subject to a 30-day notification to occupants and owners within 150-feet of the subject property. **The mailing of such notification will be performed separately.** 

### **BOARD OF APPEALS**

An appeal of the approval (or denial) of a **variance application** by the Zoning Administrator may be made to the **Board of Appeals within 10 days** after the **Variance Decision Letter** is issued by the Zoning Administrator.

An appeal of the approval (or denial) of a **building permit application** by the Planning Department may be made to the **Board of Appeals within 15 days** after the **building permit** is issued (or denied) by the Director of the Department of Building Inspection.

Appeals must be submitted in person at the **Board's office at 1650 Mission Street, 3rd Floor, Room 304**. For further information about appeals to the Board of Appeals, including current fees, **contact the Board of Appeals** at **(415) 575-6880**.

### **ABOUT THIS NOTICE**

The Planning Department is currently reviewing its processes and procedures for public notification as part of the Universal Planning Notification (UPN) Project. The format of this Public Hearing notice was developed through the UPN Project and is currently being utilized in a limited trial-run for notification of Variance Hearings.

If you have any comments or questions related to the UPN Project or the format of this notice, please visit our website at <a href="http://upn.sfplanning.org">http://upn.sfplanning.org</a> for more information.

中文詢問請電:558.6378

Para información en Español llamar al: 558.6378

# **ABBREVIATIONS**

M.D.

MIN.

MECH.

MEMB.

METAL DECK

MECHANICAL

**MEMBRANE** 

MANUFACTURER

METAL

MINIMUM

NOT ALL ABBREVIATIONS HAVE BEEN USED IN THE ARCHITECTURAL DRAWINGS. THERE MAY BE ABBREVIATIONS USED THAT ARE NOT LISTED IN THE ABBREVIATION SCHEDULE. ADVISE ARCHITECT IF THERE ARE ABBREVIATIONS USED, WHICH ARE NOT LISTED, THAT REQUIRE CONFIRMATION ON THE MEANING.

LISTED, THAT REQUIRE CONFIRMATION ON THE MEANING.					
&	AND	MIR.	MIRROR		
<	ANGLE	MISC. MISCI			
@	AT	MTD.			
C Ø	CENTERLINE DIAMETER OR ROUND	MUL.	MULLION		
#	POUND OR NUMBER	N/A	NOT APPLICABLE		
(E)	EXISTING	N.I.C.	NOT IN CONTRACT		
(N)	NEW	N.T.S	NOT TO SCALE		
	ADJUSTABLE ABOVE FINISHED FLOOR	OBS.	OBSCURE		
	AGGREGATE	O.C.	ON CENTER		
	ALUMINUM	O.D.	OUTSIDE DIAMETER (DIM.)		
	APPROXIMATE	OH	OPPOSITE HAND		
ARCH.	ARCHITECTURAL	OPNG. OPP.	OPENING OPPOSITE		
BD.	BOARD	011.	011 00112		
BLDG.		PL.	PLATE		
BLKG.		P.LAM.			
BM. BOT.	BEAM BOTTOM	PLAS. PLYWD.			
20	20.10	PR.	PAIR		
CAB.	CABINET	PT.	POINT		
CEM. CER.	CEMENT CERAMIC	R.C.P.	REFLECTED CEILING PLAN		
CLG.	CEILING	R.D.			
CLKG.	CAULKING	REF.	REFERENCE		
CLO.	CLOSET	REFR.			
CLR. CNTR.	CLEAR COUNTER	REINF. REQ.	REINFORCED REQUIRED		
CNTK. C.O.	CASED OPENING	RESIL.	RESILIENT		
COL.	COLUMN	RM.	ROOM		
CONC.	CONCRETE	R.O.	ROUGH OPENING		
CONN. CONSTR.	CONNECTION CONSTRUCTION	RWD. R.W.L.	REDWOOD RAIN WATER LEADER		
CONSTR.	CONTINUOUS	K.VV.L.	RAIN WATER LEADER		
CORR.	CORRIDOR	S.C.	SOLID CORE		
CTR.	CENTER	SCHED.	SCHEDULE		
DBL.	DOLINI E	SECT. SH.	SECTION SHOWER		
DBL. DET.	DOUBLE DETAIL	SHT.	SHEET		
DIA.	DIAMETER	SIM.	SIMILAR		
DIM.	DIMENSION	SL.	SLOPE		
DN.	DOWN DOOR ORENING	SPEC. SQ.	SPECIFICATION		
D.O. DP	DOOR OPENING DOUBLE PANE	SQ. S.ST.			
DR.	DOOR	STD.	STANDARD		
DS.	DOWNSPOUT	STL.	STEEL		
DWG. DWR.	DRAWING DRAWER	STOR. STRUC.			
DWK.	DRAWER	SUSP.			
EA.	EACH	SYM.	SYMMETRICAL		
EL.	_	S.S.D.			
ELECT. ELEV.	ELECTRICAL ELEVATOR	S.C.D. S.E.D.	SEE CIVIL DRAWINGS SEE ELECTRICAL DRAWINGS		
EQ.	EQUAL	S.P.D.	SEE PLUMBING DRAWINGS		
EQPT.	EQUIPMENT	SP	SINGLE PANE		
EXST.	EXISTING	S.L.D.	SEE LANDSCAPE DRAWINGS		
EXT.	EXTERIOR	S.M.D.	SEE MECHANCIAL DRAWINGS		
FIN.	FINISH	T.B.D.	TO BE DETERMINED		
FL.	FLOOR	TEL.	TELEPHONE		
FLUOR.	FLUORESCENT	TER. T. & G.	TERRAZZO TONGUE AND GROOVE		
FT. FTG.	FOOT OR FEET FOOTING	T. & G. TH.	THICK/THICKNESS		
FURR.	FURRING	T.O.C.	TOP OF CONCRETE		
F.D.	FLOOR DRAIN	T.O.P.	TOP OF PARAPET		
FDN.	FOUNDATION	T.O.S.	TOP OF STEEL		
GA.	GUAGE	T.P. T.O.W.	TOP OF PAVEMENT TOP OF WALL		
GALV.	GALVANIZED	T.V.	TELEVISION		
GL.	GLASS	TYP.	TYPICAL		
GYP.	GYPSUM	LINIT	LINEINICLIED		
H.B.	HOSE BIBB	UNF. U.O.N.	UNFINISHED UNLESS OTHERWISE NOTED		
H.C.	HOLLOW CORE	- · <del>-</del> · · · ·			
HGT.	HEIGHT	VERT.	VERTICAL		
HORIZ.	HORIZONTAL HOUR	V.I.F.	VERIFY IN FIELD		
HR.	NUUK	W/W.C.	WITH WATER CLOSET		
INSUL.	INSULATION	WD.	WOOD		
INT.	INTERIOR	WDW.	WINDOW		
KIT	KITCHEN	W/O W.O.	WITHOUT WHERE OCCURS		
KIT.	KITCHEN	WP.	WATERPROOF		
LAV.	LAVATORY	WT.	WEIGHT		
B # A > 4	MANZINA				
MAX. M.C.	MAXIMUM MEDICINE CHEST				
M.D.	METAL DECK				

# **GENERAL NOTES**

1. ALL WORK SHALL BE IN CONFORMANCE WTH THE FOLLOWING CODES:

2010 SAN FRANCISCO BUILDING CODE 2010 SAN FRANCISCO MECHANICAL CODE 2010 SAN FRANCSICO PLUMBING CODE 2010 SAN FRNACISCO ELECTRICAL CODE

- 2. CONTRACTOR SHALL VERIFY ALL DIMENSIONS, ELEVATIONS AND CONDITIONS AT THE SITE AND NOTIFY THE ARCHITECT IN WRITING OF ANY DISCREPANCIES IN PLANS AND SPECIFICATIONS IMMEDITELY. WORK SHALL NOT PROCEED WITHOUT ARCHITECT'S AUTHORIZATION.
- 3. ALL DIMENSIONS ARE TO FACE OF FINISH, UNLESS OTHERWISE NOTED. DO NOT SCALE DRAWINGS, CALL ARCHITECT WHERE CLARIFICATION IS REQUIRED.
- 4. DETAILS SHOWN ARE TYPICAL. SIMILAR DETAILS SHALL APPLY IN SIMILAR LOCATIONS AND CONDITIONS.
- THESE DOCUMENTS DESCRIBE DESIGN INTENT. CONTRACTOR IS RESPONSIBLE TO PROVIDE COMPLETE OPERATIONAL SYSTEMS AND INSTALLATIONS. NO CLAIMS FOR ADDITIONAL WORK WILL BE AWARDED FOR WORK WHICH IS DESCRIBED IN THESE DOCUMENTS OR WHICH IS REASONABLY INFERABLE FROM THEM.
- CONTRACTOR IS RESPONSIBLE FOR THOROUGH COORDINATION OF TRADES, NO CLAIMS FOR ADDITIONAL WORK WILL BE AWARDED FOR WORK RELATED TO SUCH COORDINATION.
- 7. ALL PLUMBING, ELECTRICAL AND HVAC WORK WILL BE PERFORMED UNDER SEPERATE DESIGN BUILD PERMITS FILED UNDER THIS APPLICATION.
- ANY HAZARDOUS MATERIALS ARE TO BE REMOVED PRIOR TO CONSTRUCTION. ANY QUESTIONS THAT ARISE RELATED TO ASBESTOS SHALL BE REFERRED TO THE OWNER FOR RESOLUTION. ALL CONTRACTORS AND SUB-CONTRACTORS SHALL REPORT THE PRESENCE OF ANY MATERIAL OR ASSEMBLY SUSPECTED TO CONTAIN ASBESTOS UPON DISCOVERY. THE WORK SHALL BE CARRIED OUT PER THE CONSULTANTS RECOMMENDATIONS OUTSIDE OF THE WORK DESCRIBED IN THIS PERMIT.

# **DIRECTORY**

# <u>Owners</u> Lisa Caccavo and Friedmann Thomma

3647 22nd St. San Francisco, CA

E: LCaccavo@crowell.com

## Designer/ Owners Rep. David Straton

830 Bush St. #204 San Francisco, CA 94108 P.310.592.2477 E:DS2SF@yahoo.com

# Architect:

Joel M. Karr 351 California St. suite 350 San Francisco, CA 94104

# PROJECT INFORMATION

Project Description:

Side infill for new stair (55 SQ.FT.) from main floor level to basement/lower level and out to rear yard.

Legalize the (E) lower basement unit (occupancy change from 1 unit to 2 units) as well as adding an egress window in the units bedroom area.

Job Address: 3647 22nd St., San Francisco, California

Block #: 3627 Lot #: 045 Site Area: 2,722 SF

Floor Area (Habitable Space): Existing 1,858 SQ.FT.

Proposed: 332 SQ.FT. LEGALIZE 332 SQ.FT. Basement/1st Floor Main Floor 1,188 SQ.FT. 670 SQ.FT. Upper Floor

2,190 SQ.FT.

1,243 SQ.FT.

670 SQ.FT.

2,245 SQ.FT.

Zoning: R3 Occupancy

# **SHEET INDEX**

Architectural

Cover Sheet, Project Information & Site Plan

Main Floor Plans

A2.0 A2.1 Lower Floor Plans **Upper Floor Plans** 

Description


A2.2 A4.0 Elevations A4.1 **Eelevations and Section** 

Photo Survey

# **VICINITY MAP**



# **BLOCK MAP**

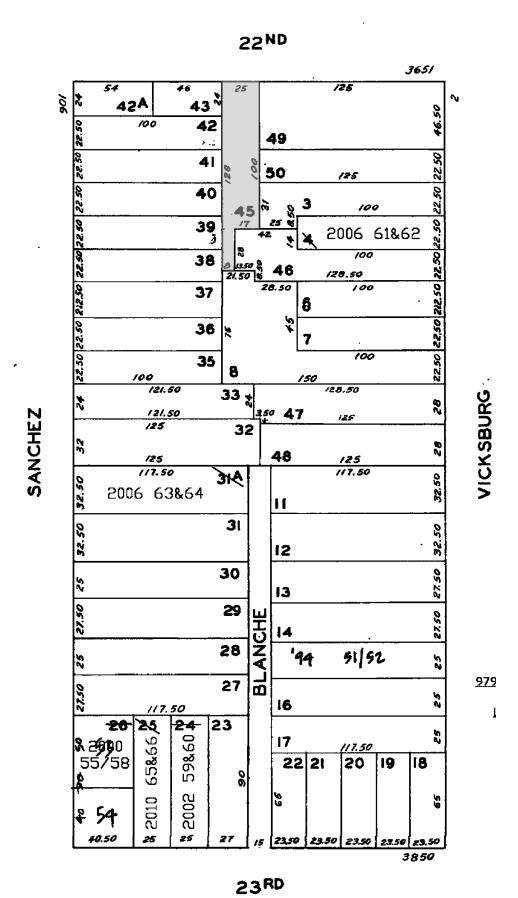

# SITE PLAN

\_ - - - \_ - - \_ - - \_ |

— -- — -- <del>|</del> -- <del>|</del> -- <del>|</del>

FRONT

(N) 2ND FLR

DOWN TO

55 SQ.FT.

3'-5" 3'-9"

STAIR ADDITION


LOWER FLOOR

**22ND ST.** 

SITE PLAN

SCALE: 1/8" = 1' - 0"

25'-0" SUBJECT PROPERTY

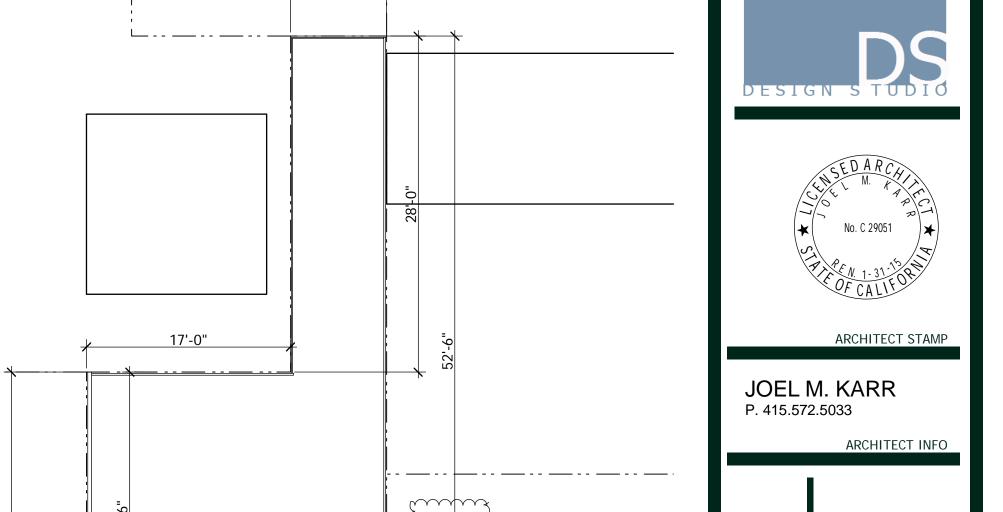

45% REAR YARD SETBACK LINE


# STRA 830 FRANC

DAVID STRATON


2013.07.08 Site Permit 2013.08.30 Rev. 1 to Site Permit 2013.08.30 Variance

DAV

SITE PLAN, PROJECT INFO AND COVER SHEET

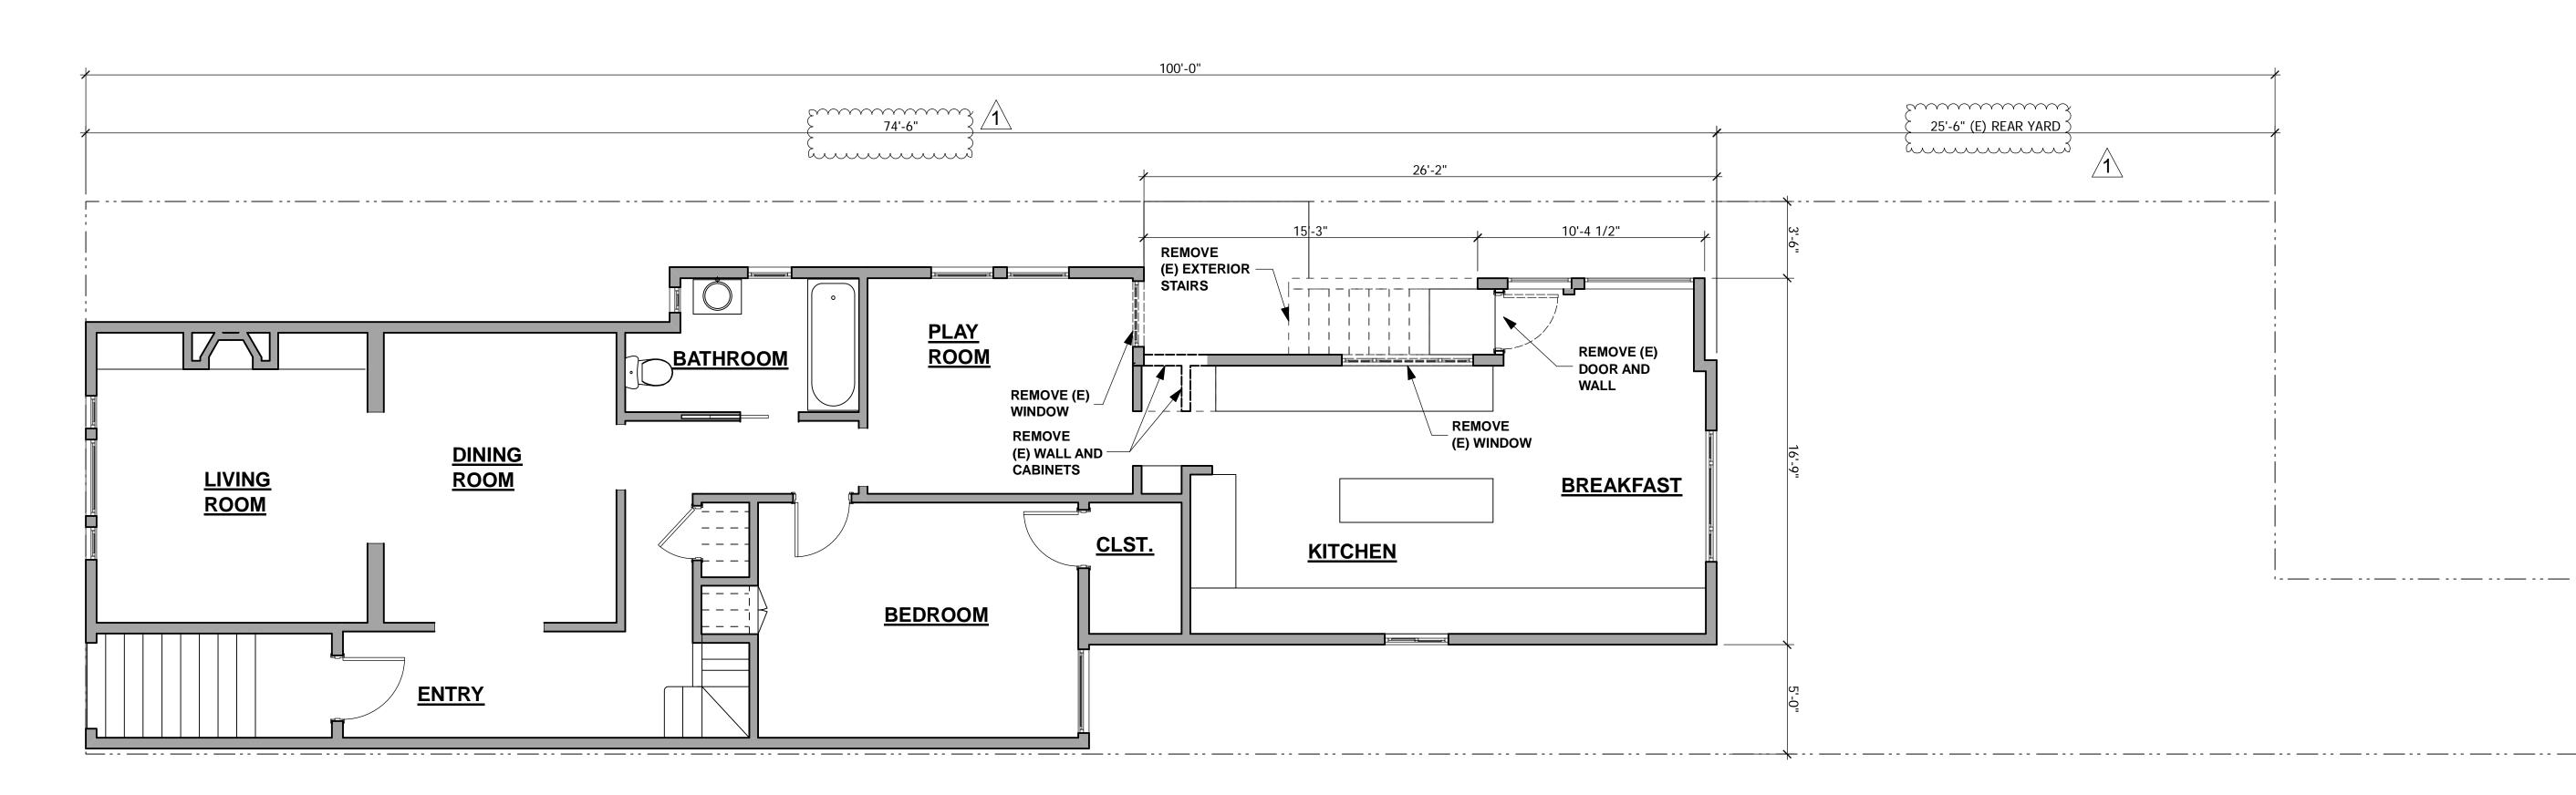

2 EXISTING/DEMO MAIN FLOOR PLAN

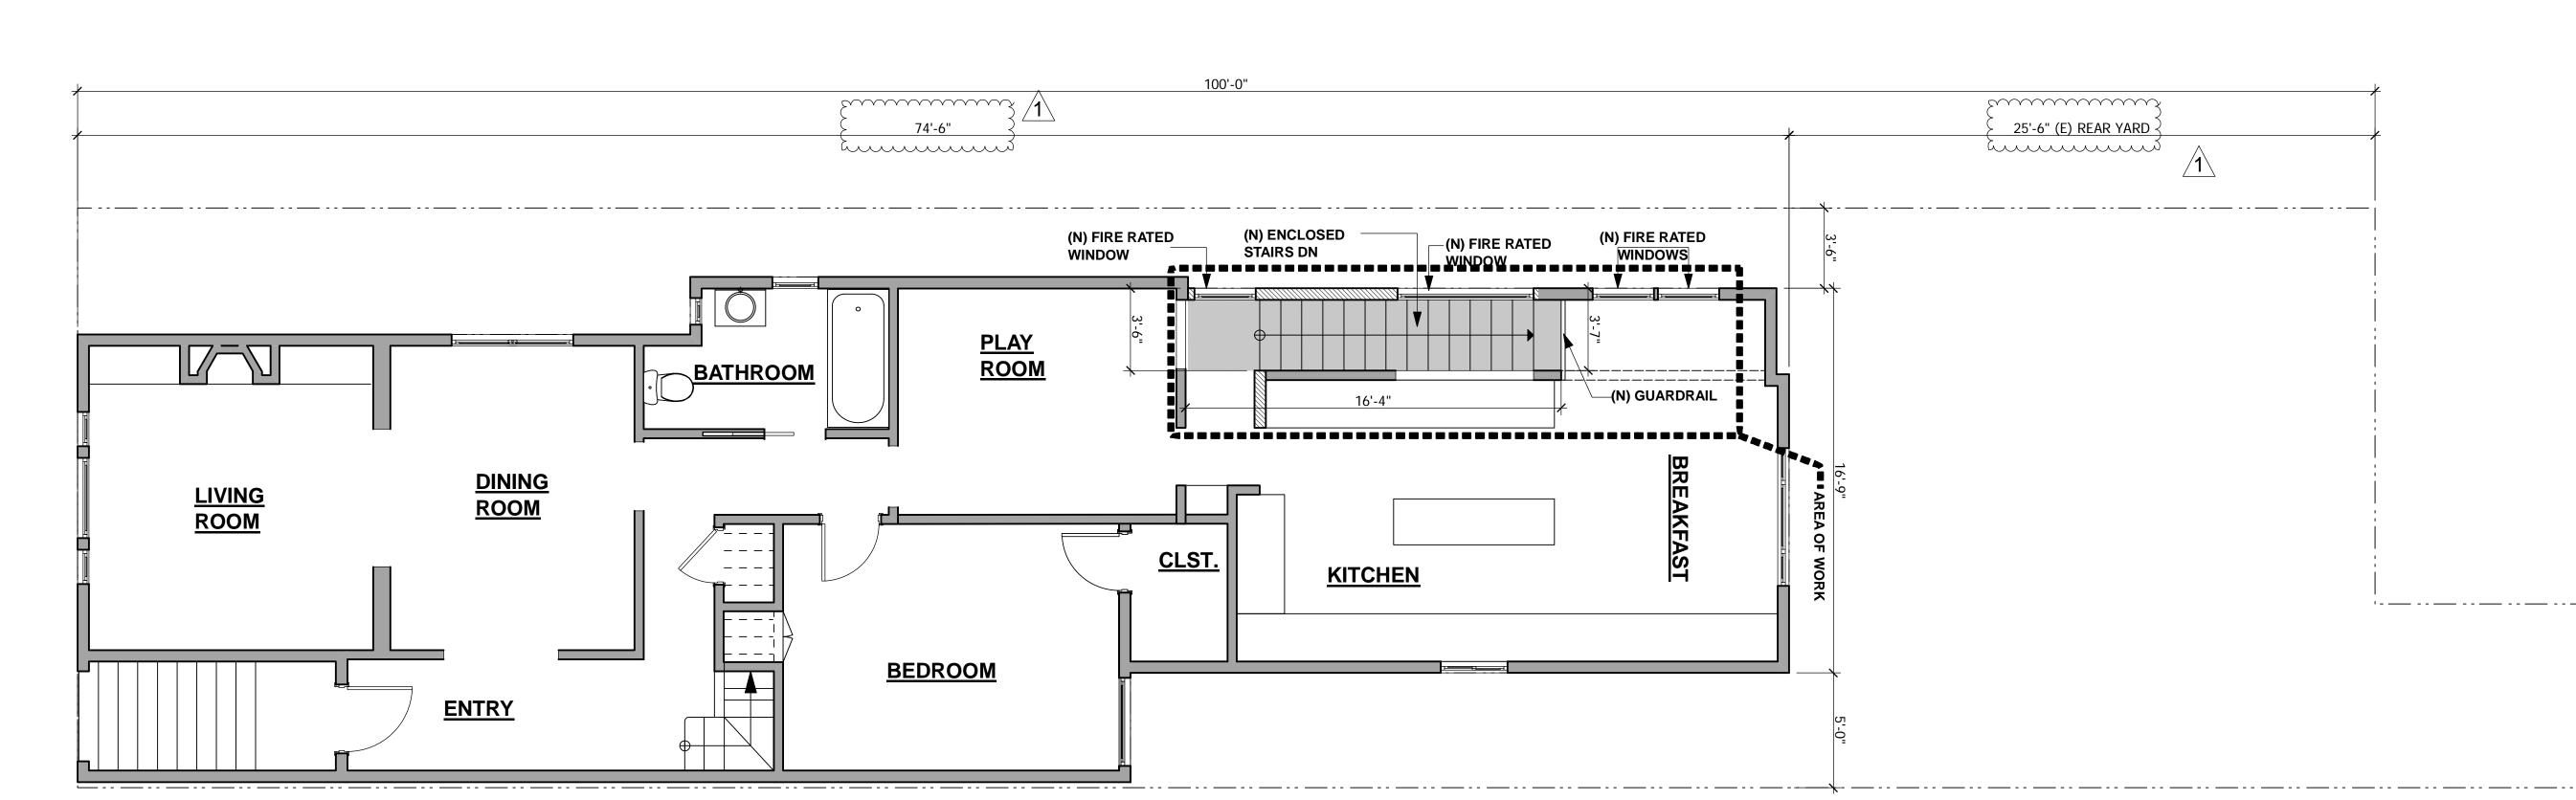

PROPOSED MAIN FLOOR PLAN

2





JOEL M. KARR P. 415.572.5033

ARCHITECT INFO

ARCHITECT STAMP

0

DAVID STRATON DESIGN STUDI 830 BUSH ST. #204

DATE ISSUED


2013.07.08 Site Permit


2013.08.30 Rev. 1 to Site Permit

2013.08.30 Variance

A2.0

MAIN FLOOR PLANS, EXISTING AND PROPOSED

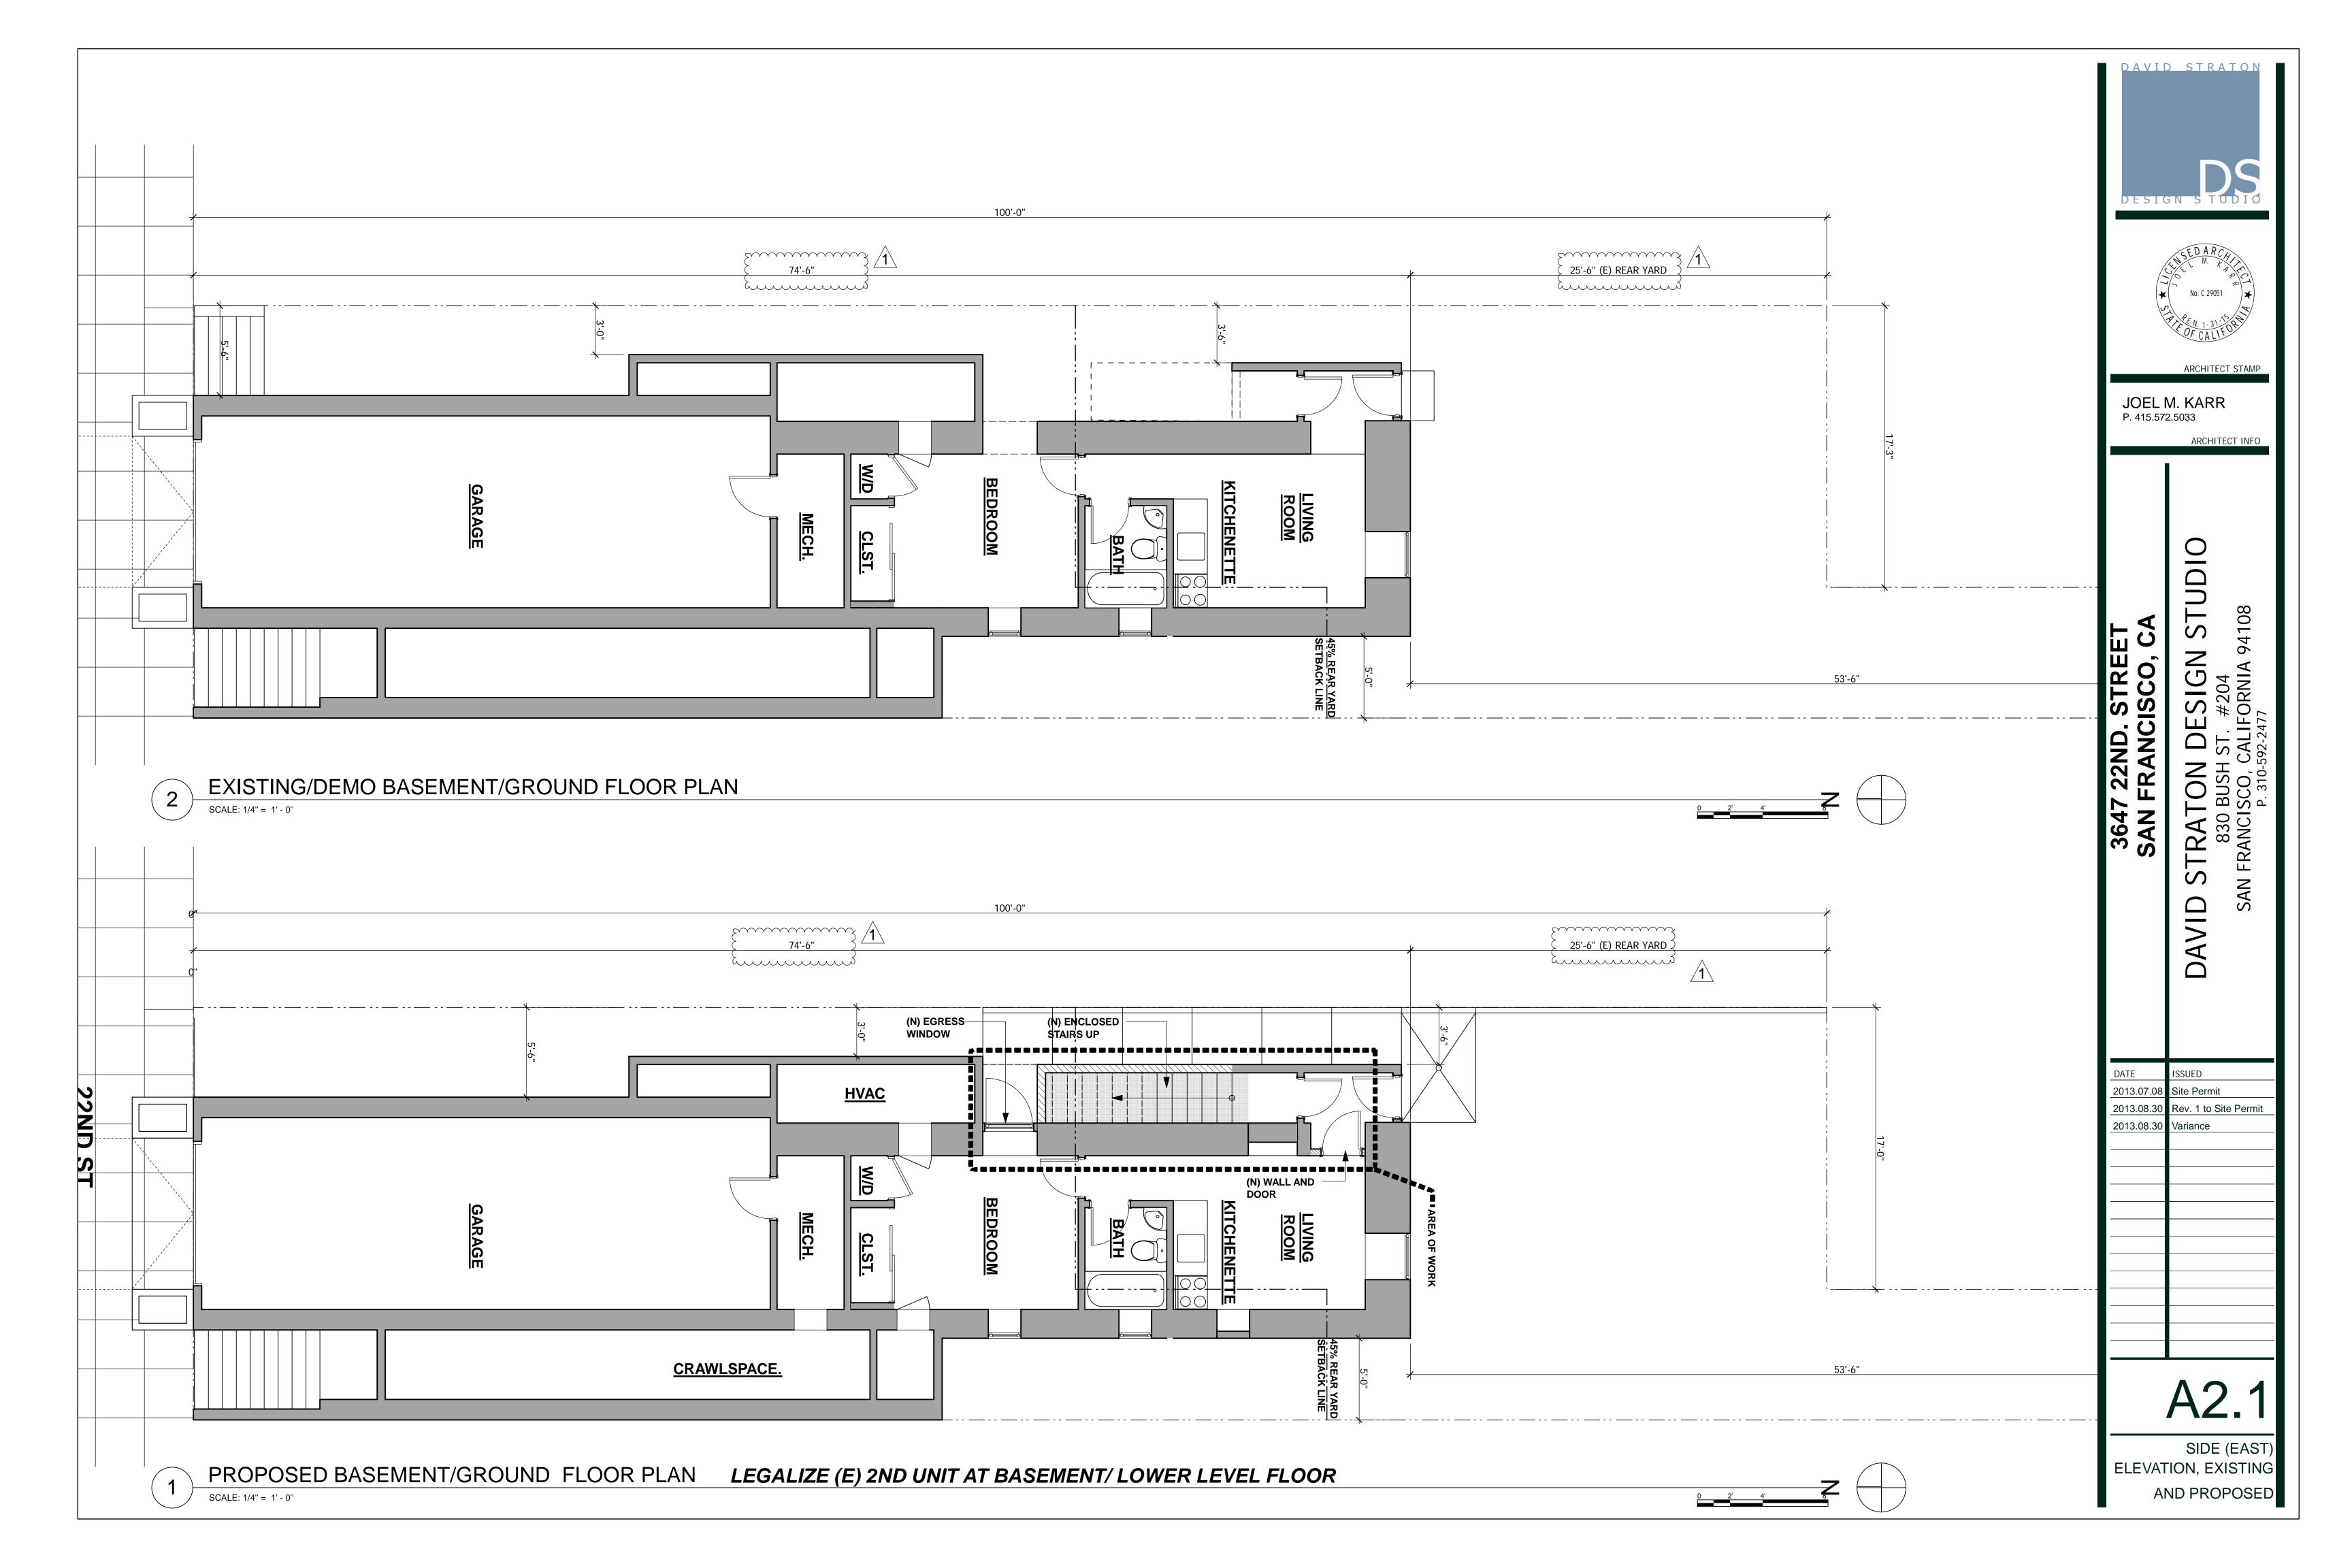

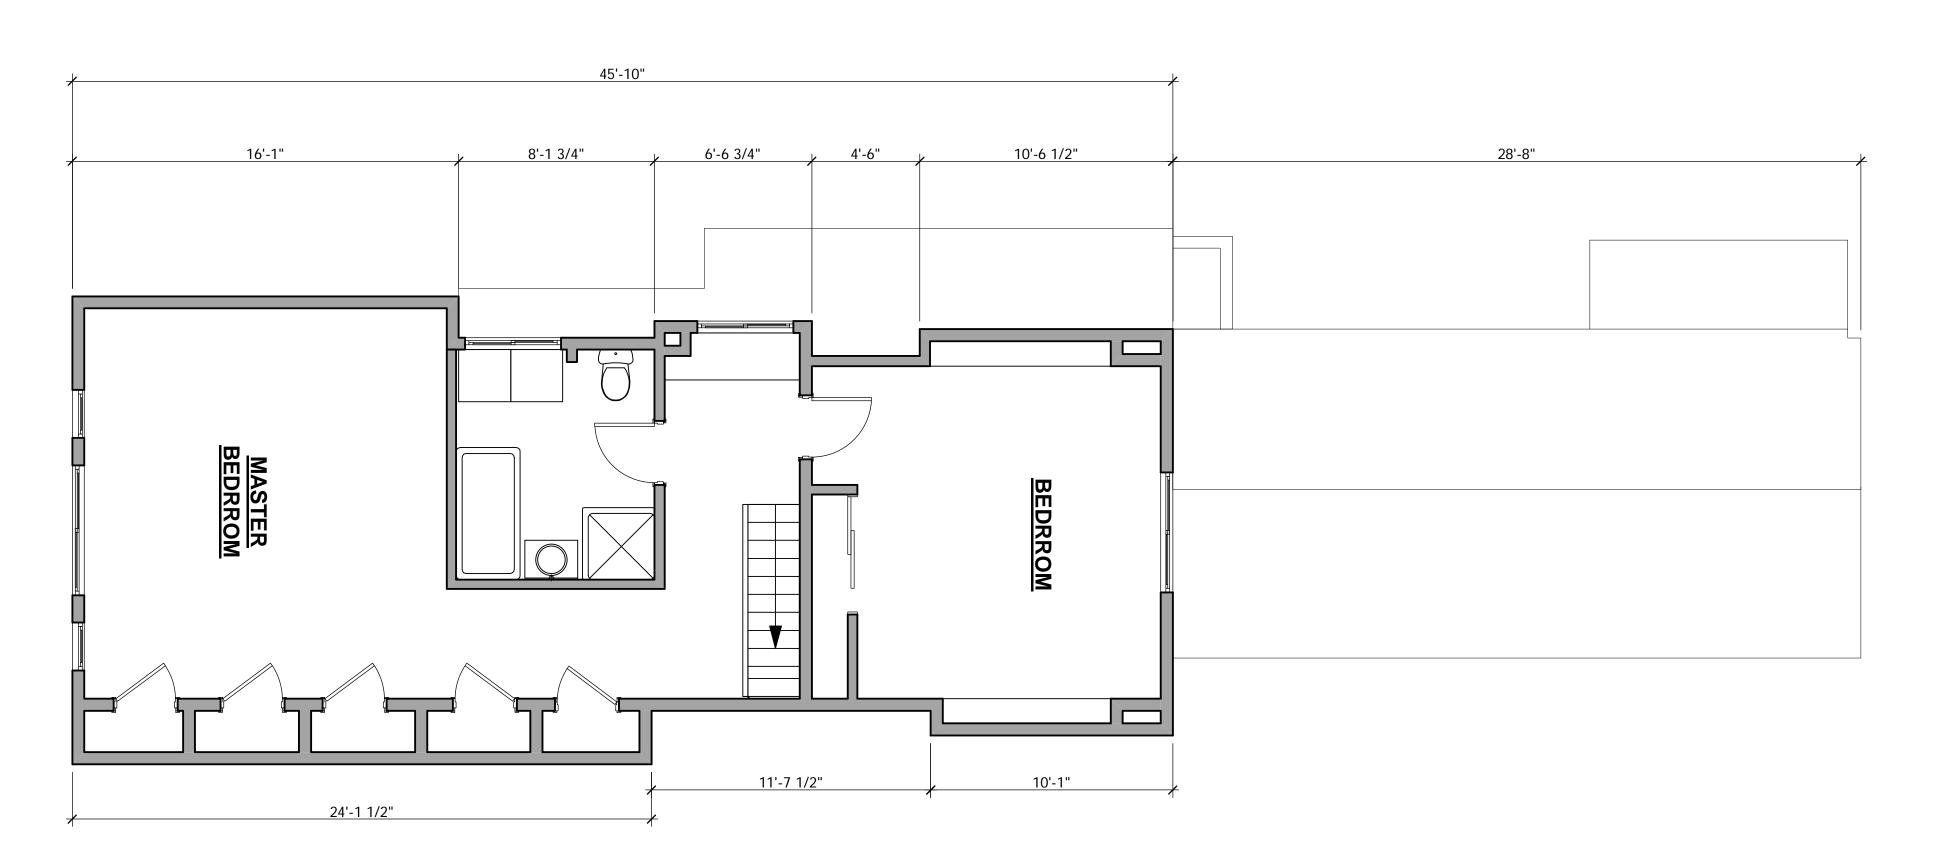

DATE ISSUED

2013.07.08 Site Permit

2013.08.30 Variance

A2.2

JOEL M. KARR P. 415.572.5033

3647 22N
SAN FRAI
ID STRATON
830 BUSH S
SAN FRANCISCO, CA


DAVID


ARCHITECT INFO

UPPER FLOOR PLAN (FOR REFERENCE)

1 EXISTING UPPER LEVEL FLOOR PLAN (FOR REFERENCE ONLY, NO WORK)

SCALE: 1/4" = 1'-0"

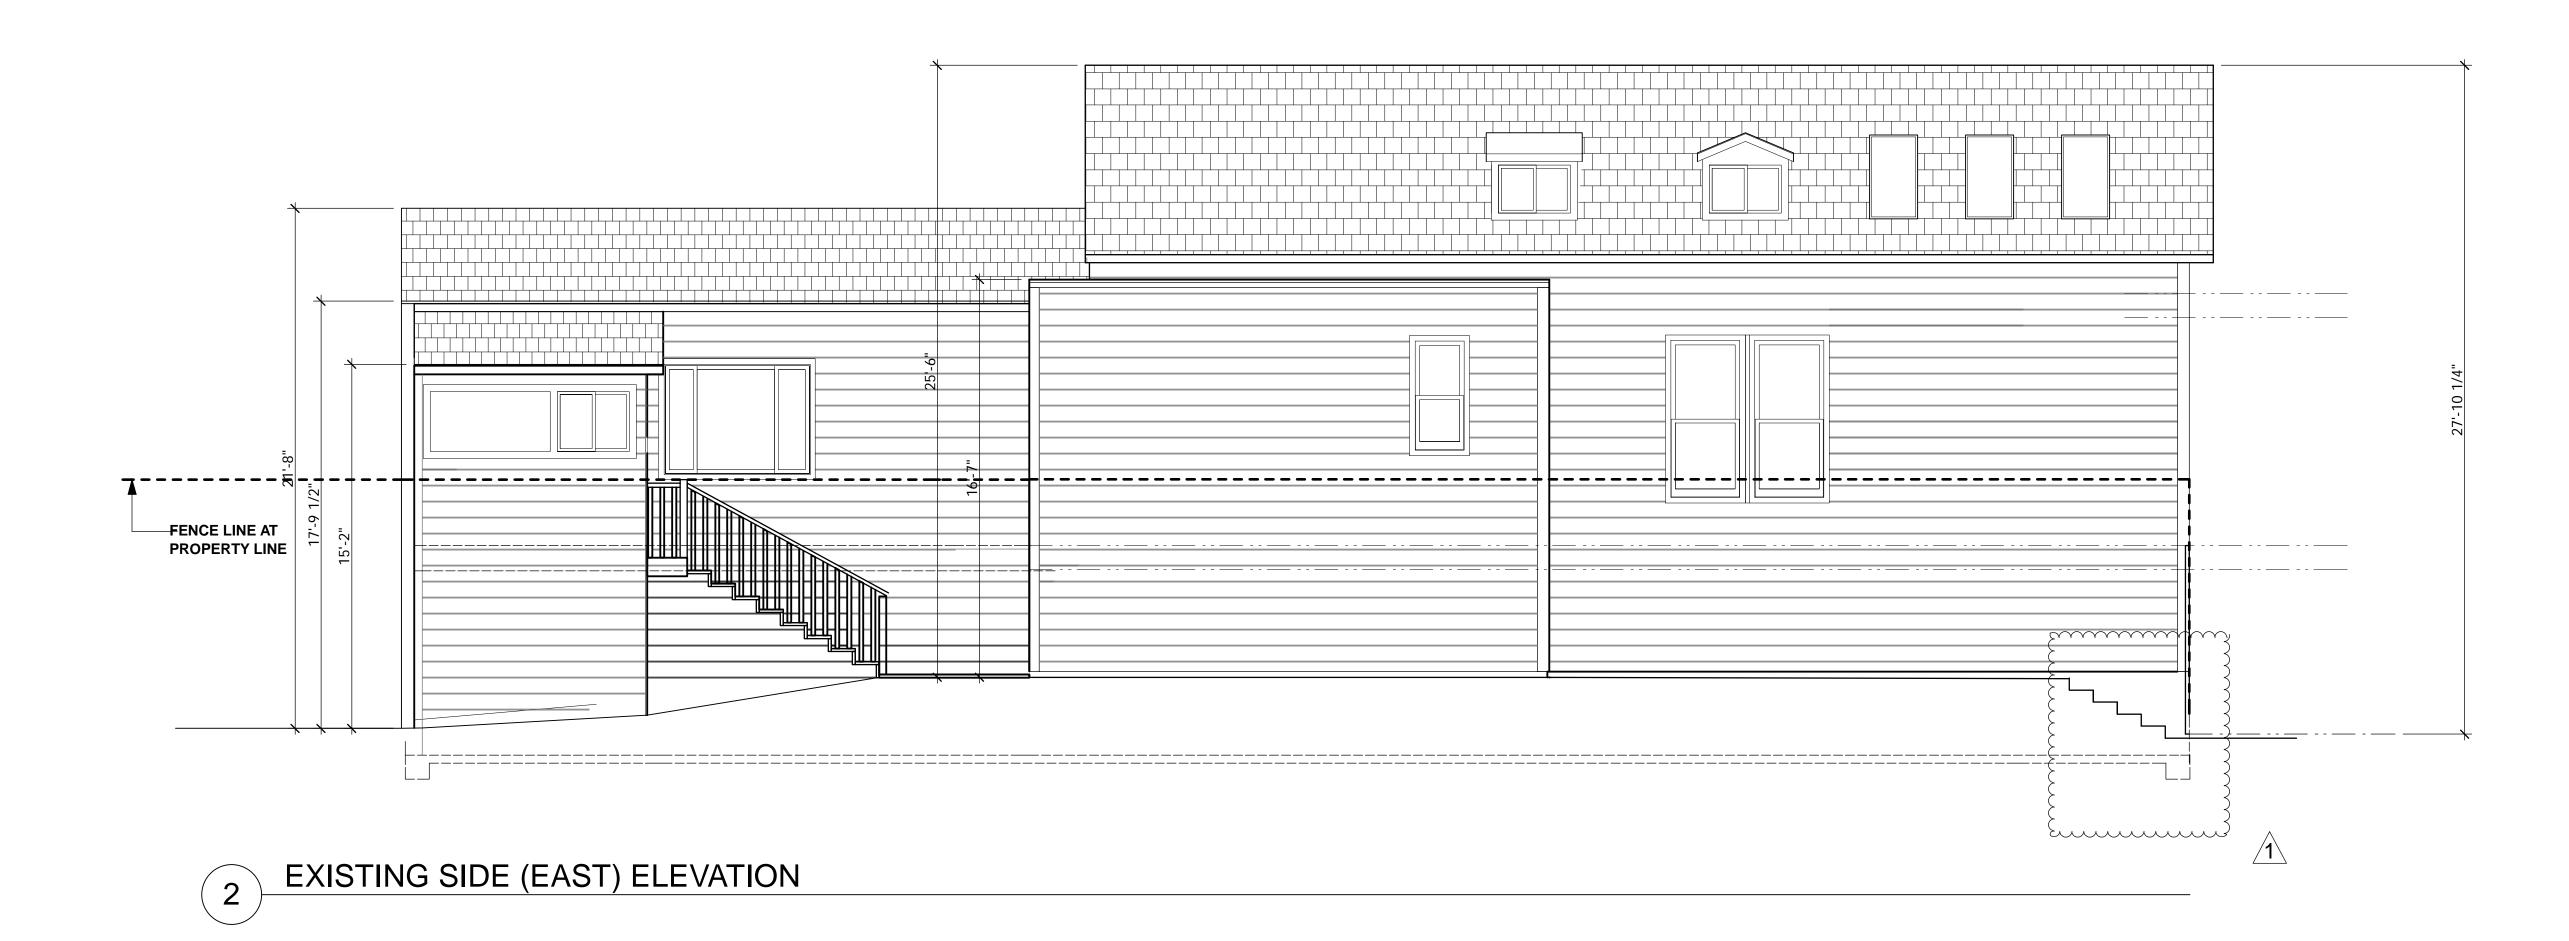

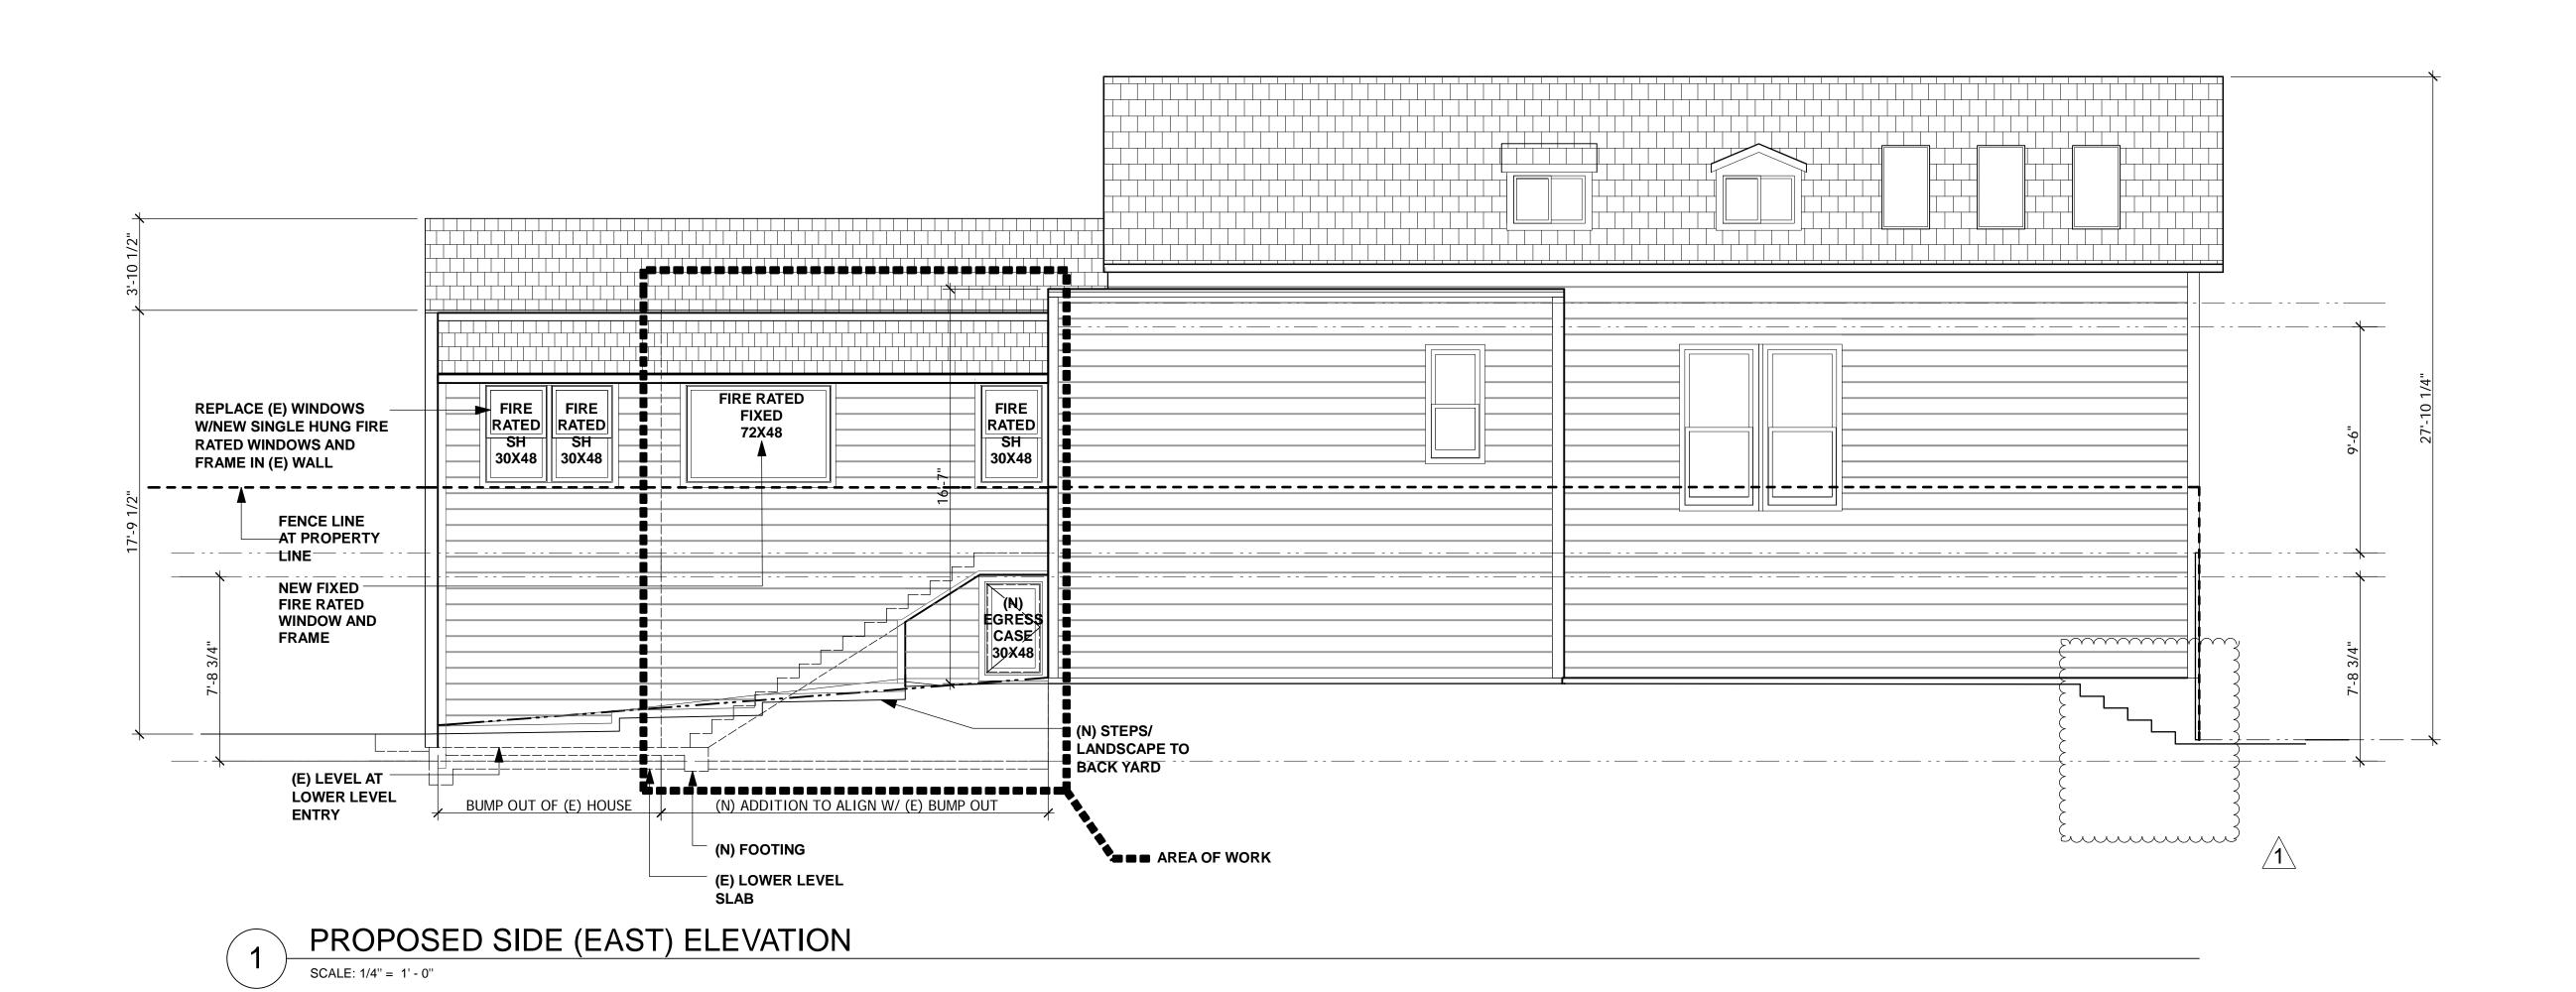




SIDE (EAST) ELEVATION, EXISTING AND PROPOSED









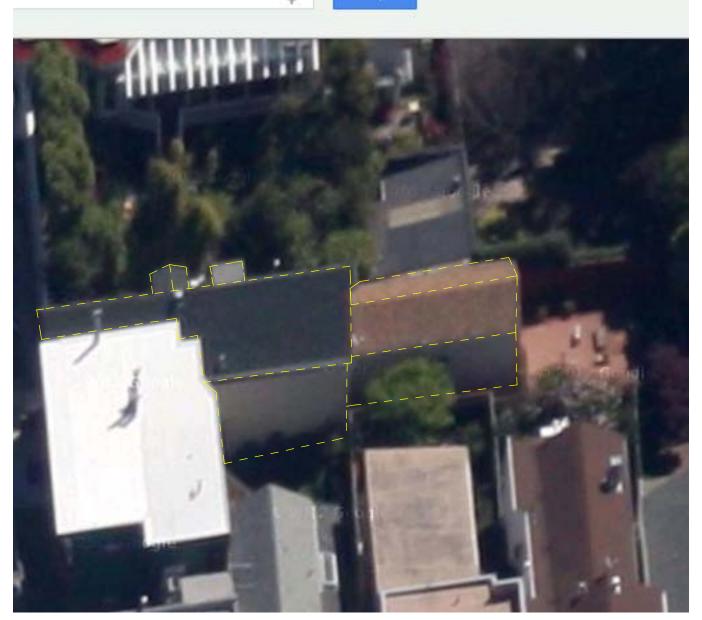

**AERIAL VIEW WEST** 

**AERIAL VIEW NORTH** 

**AERIAL VIEW EAST** 

**AERIAL VIEW SOUTH** 

SOUTH SIDE OF 22ND. STREET, VIEW FROM NORTH <u>EAST</u>

SOUTH SIDE OF 22ND. STREET, VIEWFROM NORTH WEST







NORTH SIDE OF 22ND. STREET, VIEW FROM SOUTH



NORTH SIDE OF 22ND. STREET, VIEW FROM SOUTH EAST





JOEL M. KARR P. 415.572.5033

ARCHITECT INFO

DAVID

A5.0

PHOTO SURVEY